



\\HALEYALDRICH.COM\SHARE\PHX\_COMMON\PROJECTS\FLORENCE COPPER\138706 FLORENCE FEASIBILITY\DRAWINGS\EPWELL\ABANDON\2018\_10\133S\_ABANDON.DWG  
Printed: 10/22/2018 6:43 PM Sheet: DIAGRAM  
Saved by: GKM

### AS-BUILT 133S COREHOLE

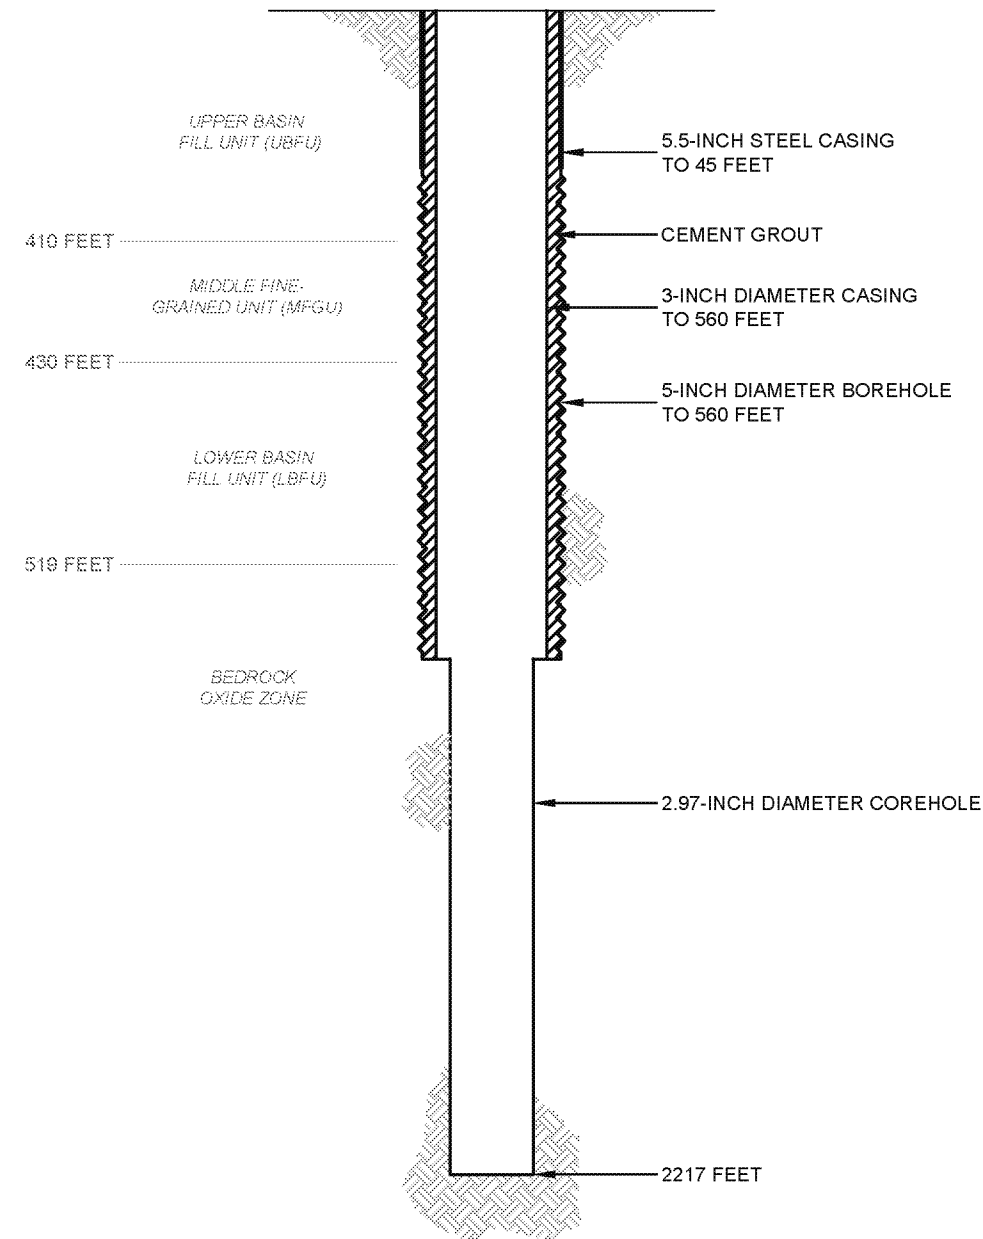

### PROPOSED PLUGGING AND ABANDONMENT 133S COREHOLE

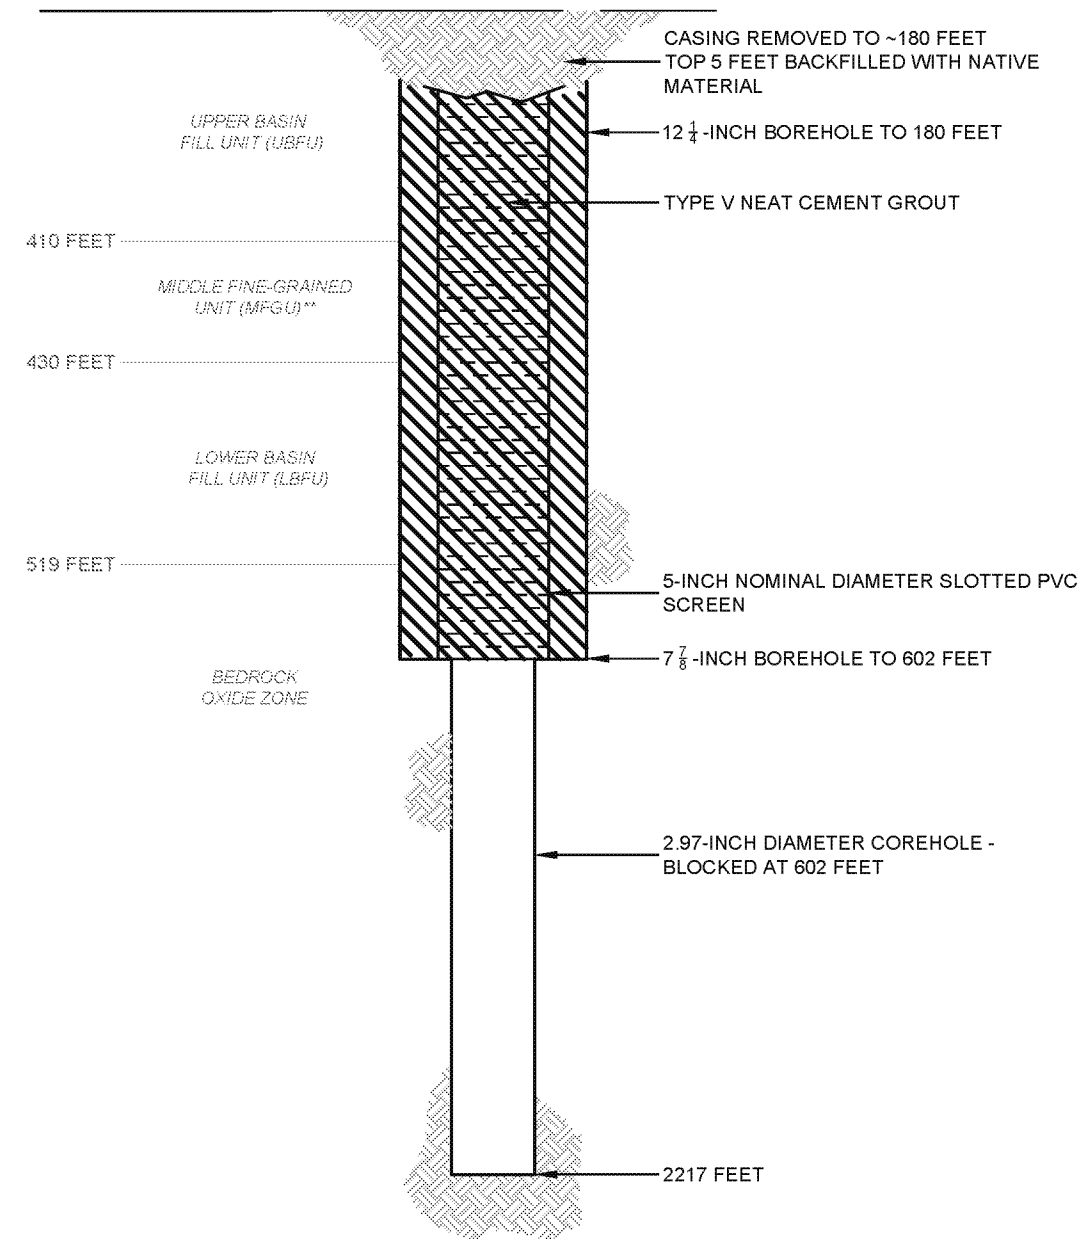

#### NOTES

- \* SCREENED PVC INSTALLED TO FACILITATE INSTALLATION OF BLASTING PERFORATION MATERIALS IN OPEN BOREHOLE.
- \*\* MFGU CONTACT PER 1971 DRILLERS LOG, CONTACT HAS NOT BEEN VERIFIED.

**HALEY  
ALDRICH**

FLORENCE COPPER, INC.  
PRODUCTION TEST FACILITY  
FLORENCE, ARIZONA

#### 133S COREHOLE ABANDONMENT DIAGRAM

**FLORENCE  
COPPER**

SCALE: NOT TO SCALE  
OCTOBER 2018